



VICTORIA, B.C. ESQUIMALT DISTRICT. —
 NAVAL YARD. BLACKROCK BATTERY, — RECORD PLANS OF —
 EMPLACEMENT FOR TWO 12PS Q.F. GUNS. —

DRAWING N^o 2 (OF 11).
 RECORD PLAN - B.


SURFACE PLAN, SCALE 20 FEET TO ONE INCH (R.F. 1/200)
 DETAILS, SCALE 10 FEET TO ONE INCH (R.F. 1/100)

ADDITIONS
 TELEPHONE CABINET, ITEM SPECIAL, W.D. CANADA No. 1071, PART I.
 DATED 213-04. ACTUAL COST \$ 4000.

AUTHORITY FOR COMMENCEMENT OF WORK, W.D. CANADA 547 OF 19-9-98.
 DATE OF COMMENCEMENT OF THE WORK, 15-10-98.
 Do COMPLETION Do. \$ 5.00.
 ESTIMATED COST \$ 24000-00
 ACTUAL Do. \$ 24000-00

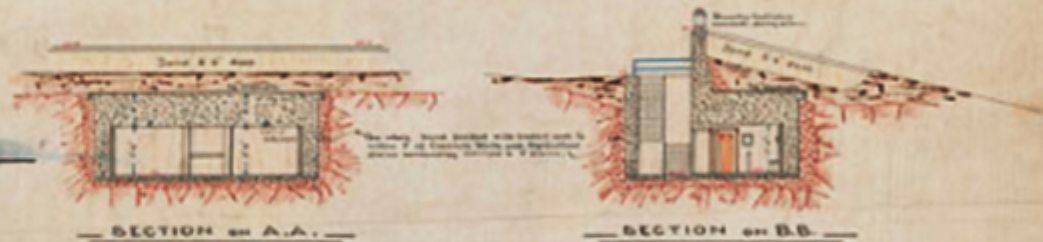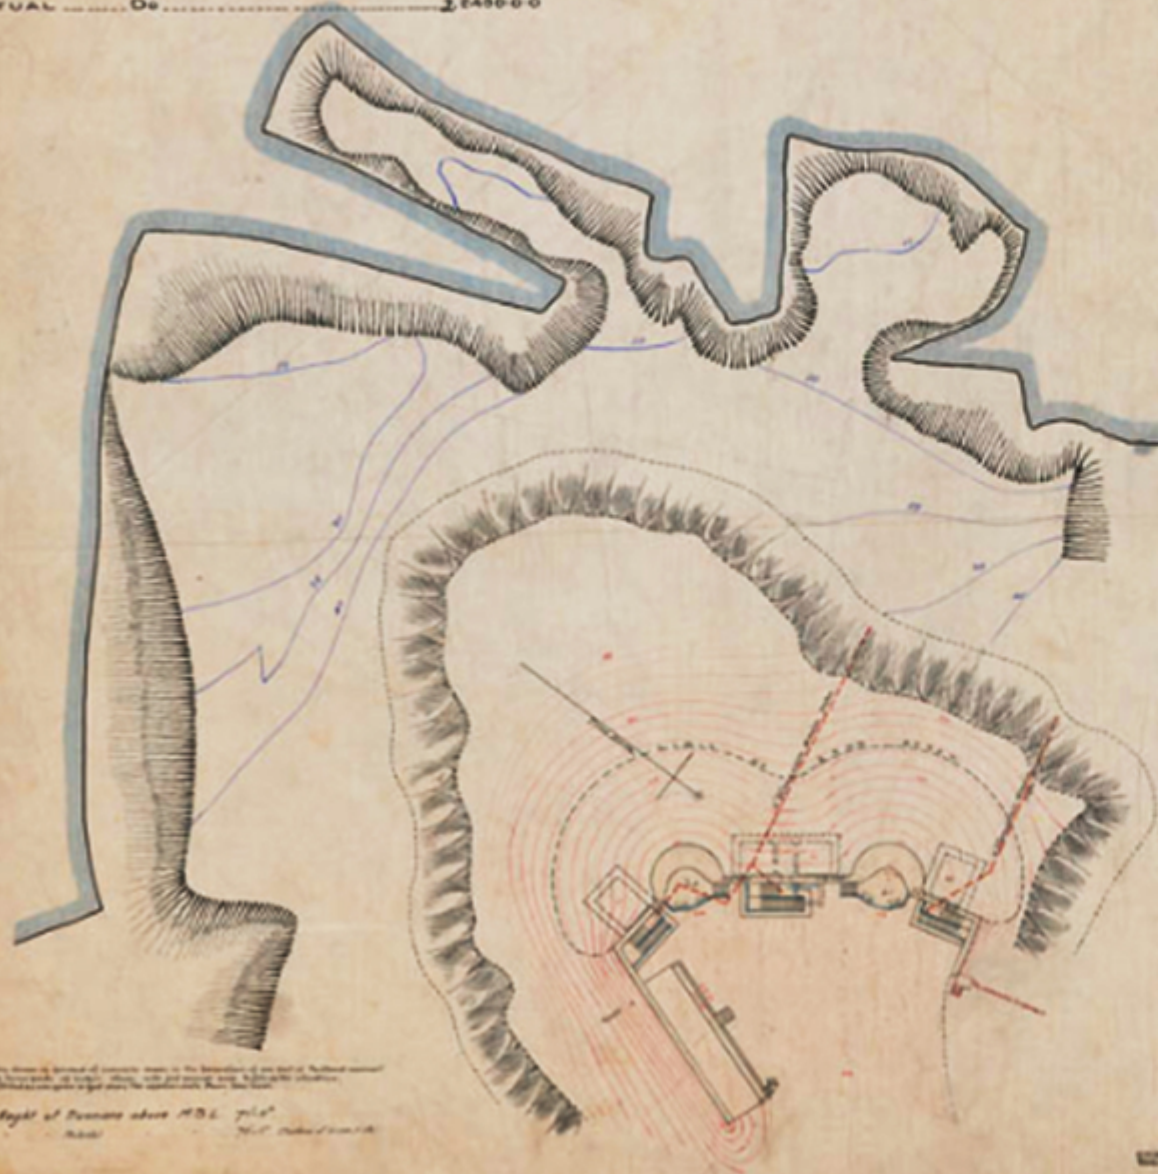

NOTE
 Earth masonry of concrete masonry, masonry about 12 inches
 building masonry 12 inches (R.F. 1/100), do. do. 1/200

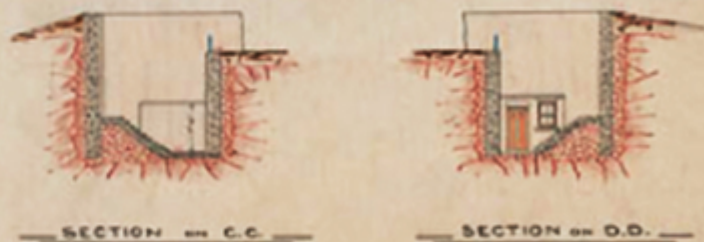

The bases of general of concrete masonry in the foundation of any part of building masonry
 shall be made of masonry, unless the soil is found to be of a nature to require a different material.
 Height of finished ground about 435.7 ft
 M.S.P. datum of masonry

Drawn by
 Geo. Ferguson, S.E. 11
 27th May 1903

H. Rand
 LT. COLONEL,
 O.C. R.E. ESQUIMALT,
 9th April 1903

VICTORIA, B.C. NAVAL YARD
 DRAWING N^o 2 (OF 11)
 RECORD PLAN - B.