

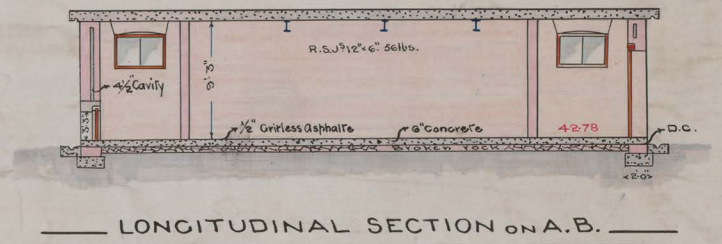
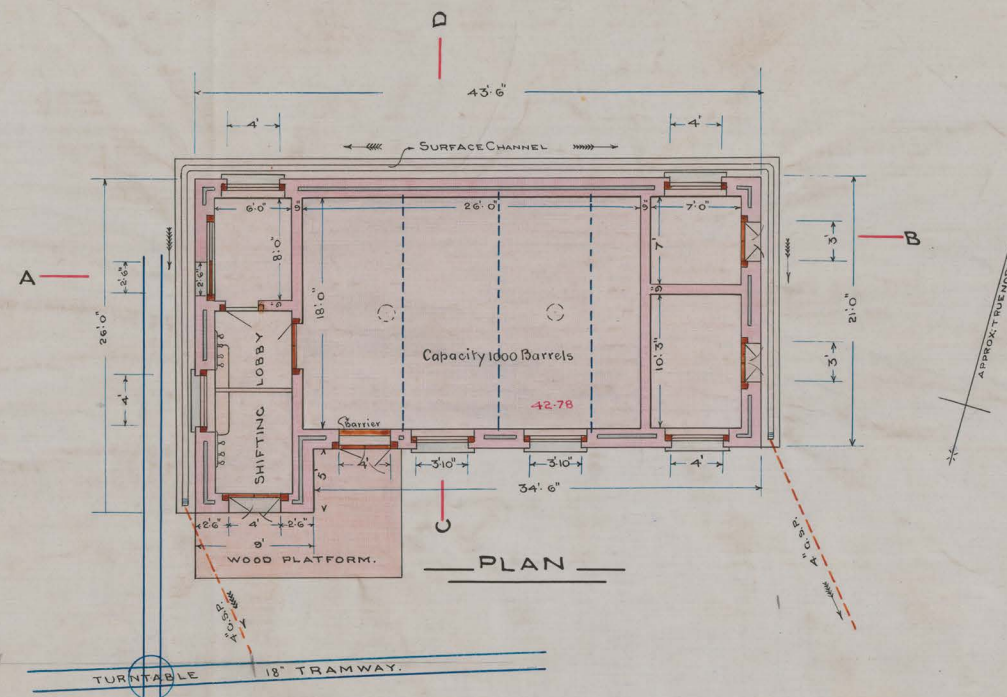


VICTORIA, B.C. ESQUIMALT DISTRICT, —  
 SIGNAL HILL, ARMY ORDNANCE ESTABLISHMENT, —  
 RECORD PLAN OF S.A.A. STORE AND MAGAZINE, —





SCALE EIGHT FEET TO ONE INCH (R.F. 1/80).

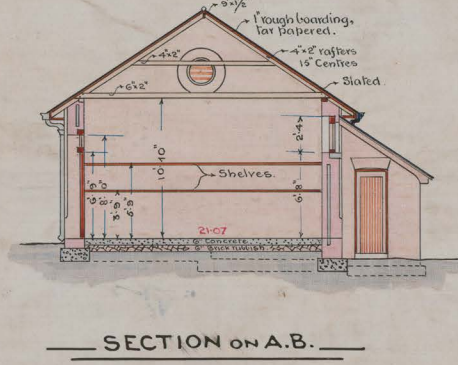

BLDG. NO. 511  
(OLD PLAN)


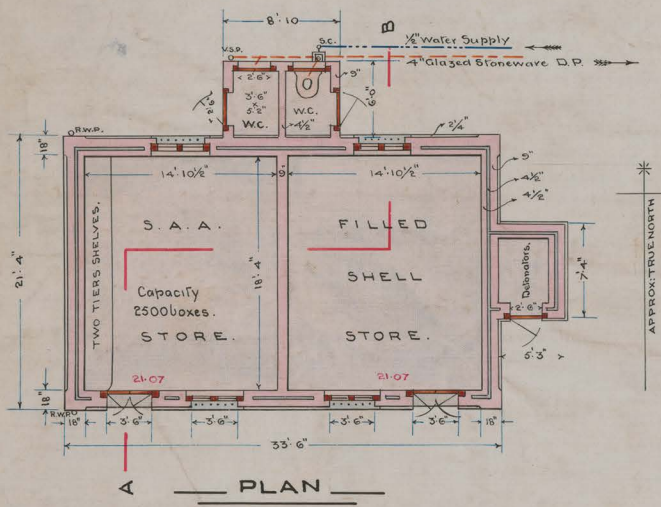


BLDG. NO. 512  
(OLD PLAN)

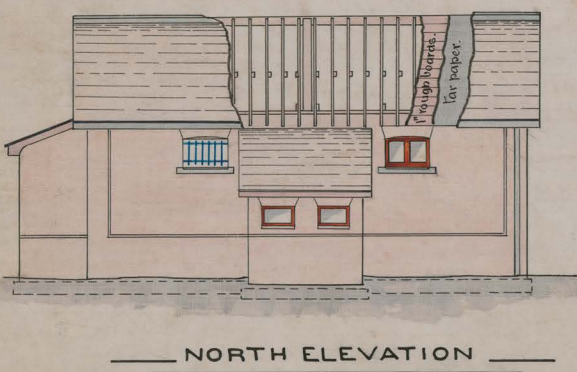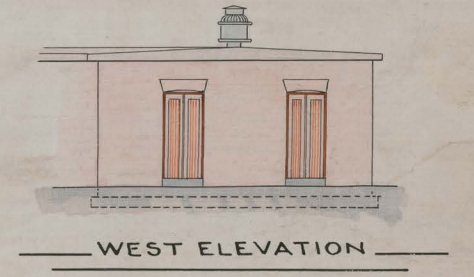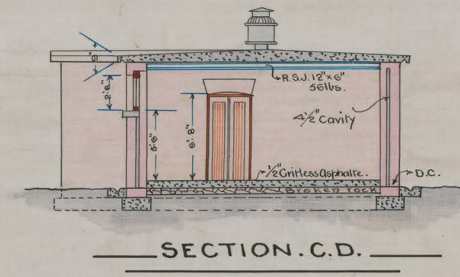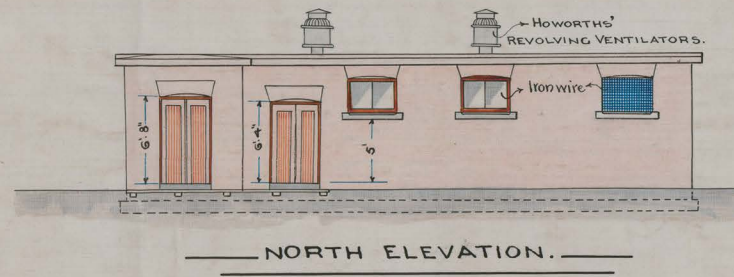

KEY PLAN

SCALE 80 FEET TO 1 INCH

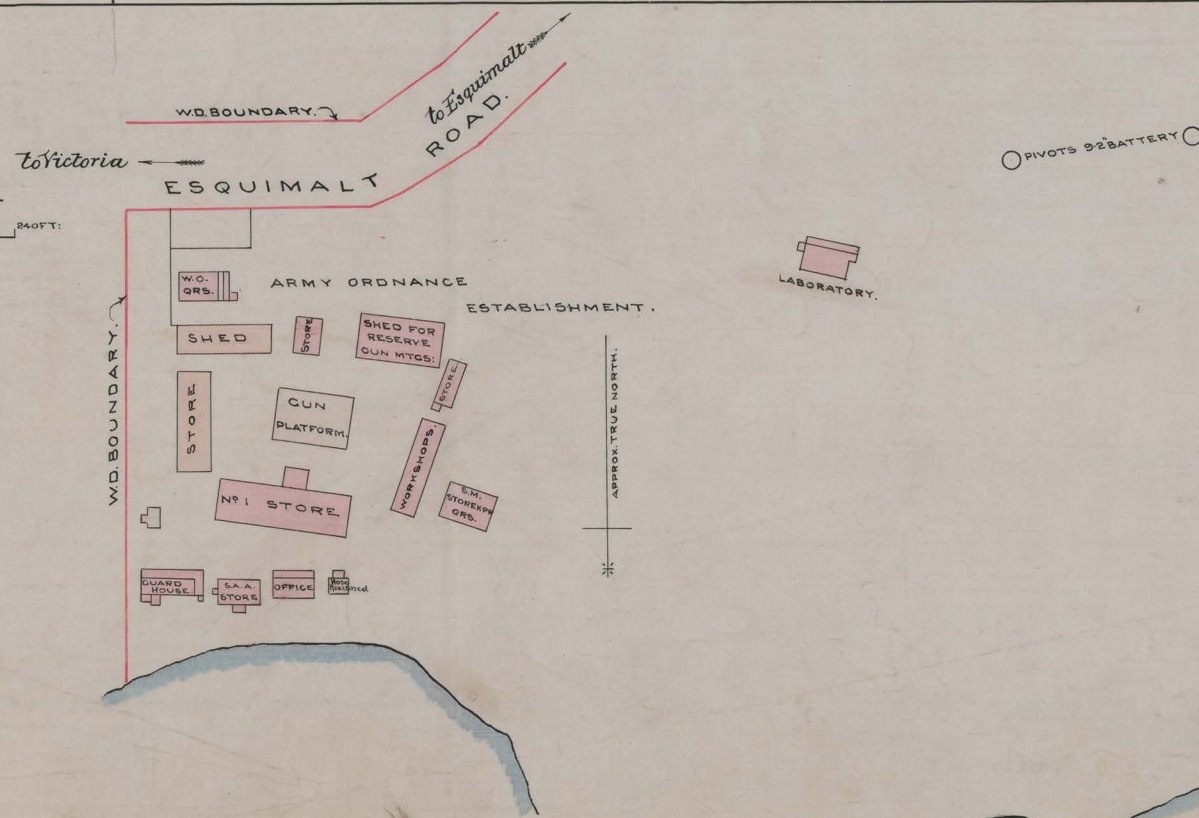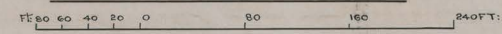

	MAGAZINE	S.A.A. STORE
DATE OF AUTHORITY TO COMMENCE	W.D. CANADA 12 d/12.11.02.	W.D. CANADA 12 d/17.2.03.
DATE OF COMMENCEMENT	28.1.03.	1.3.03.
DATE OF COMPLETION	3.9.04.	23.11.03.
ESTIMATED COST	£ 1329	£ 260
ACTUAL COST	£ 1328	£ 260
BUILT OF LOCAL RED BRICK	CONCRETE ROOF	SLATE ROOF.

DRAWN BY,  
Geo. Fontana, S.C.R.E.,  
10<sup>th</sup> MAY 1905.

H. P. Dhand  
 MAJOR, R.E.,  
 O.C., R.E., ESQUIMALT,  
 15<sup>th</sup> May - 1905.  
 MAGAZINE BLDG - SIGNAL HILL  
 VICTORIA DR. NO. 18A TRACING NO. 3  
 VANCOUVER DR. NO. TRACING NO.

79